
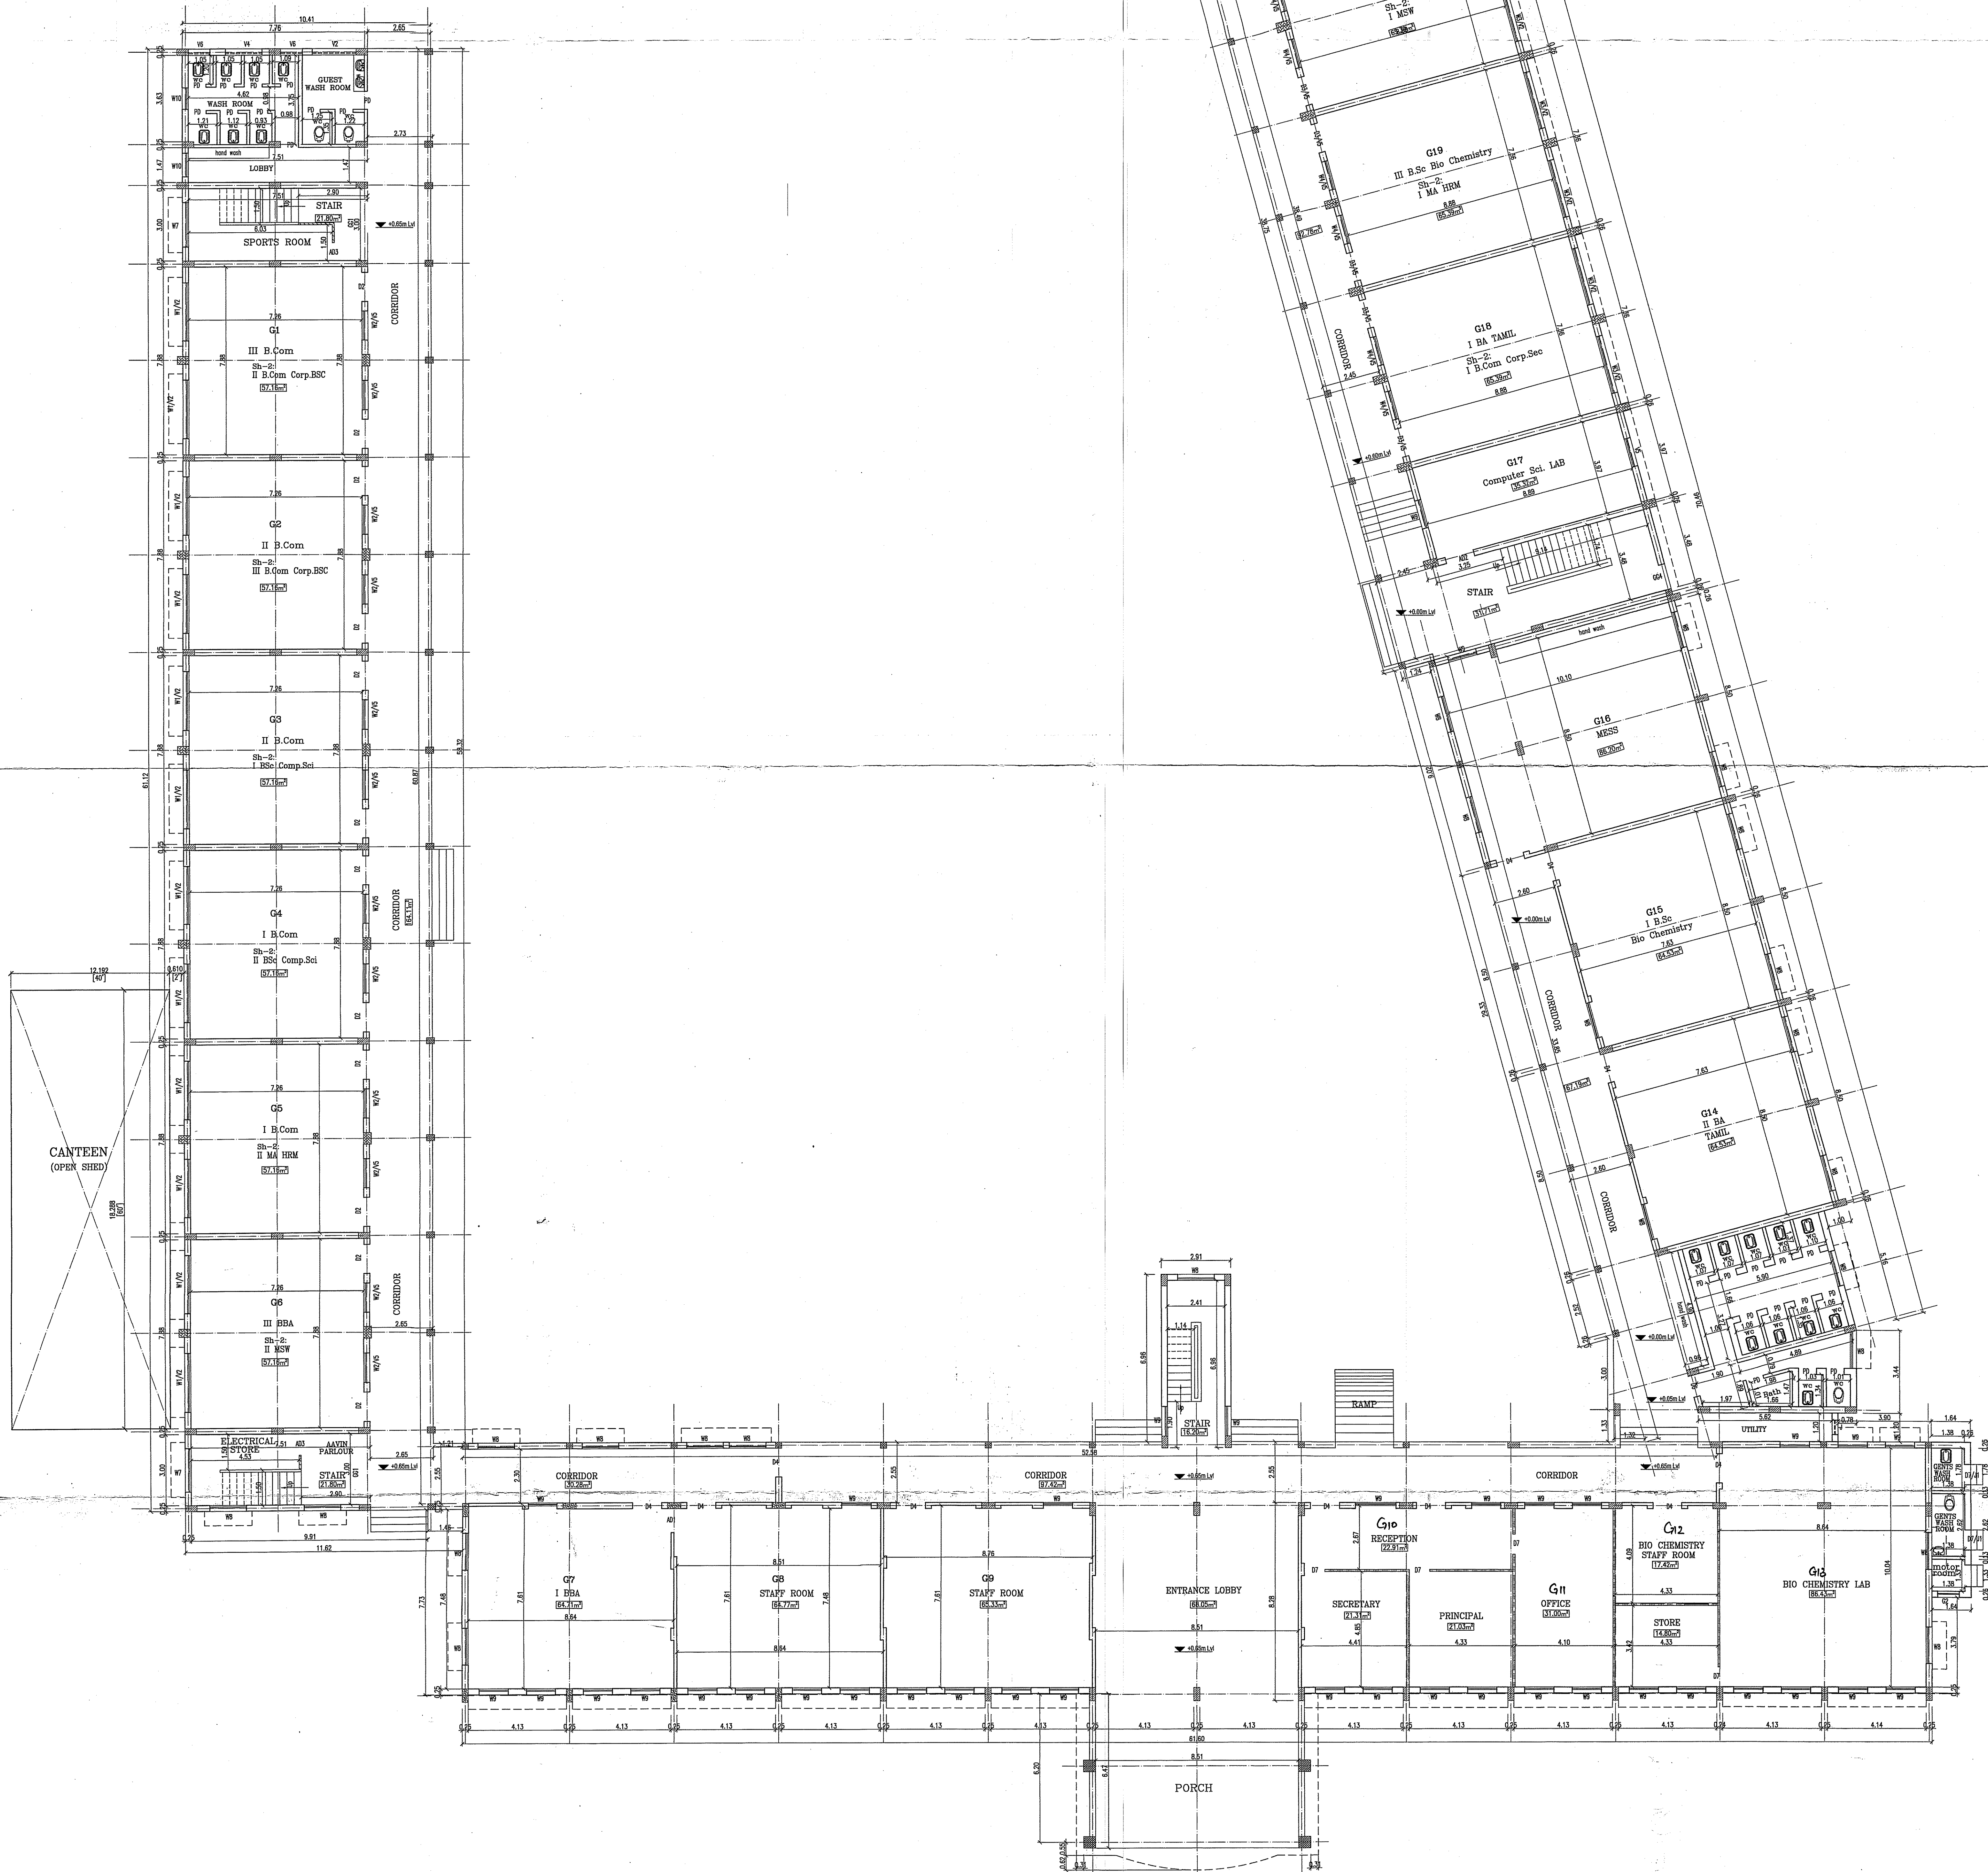


ORIENTATION:

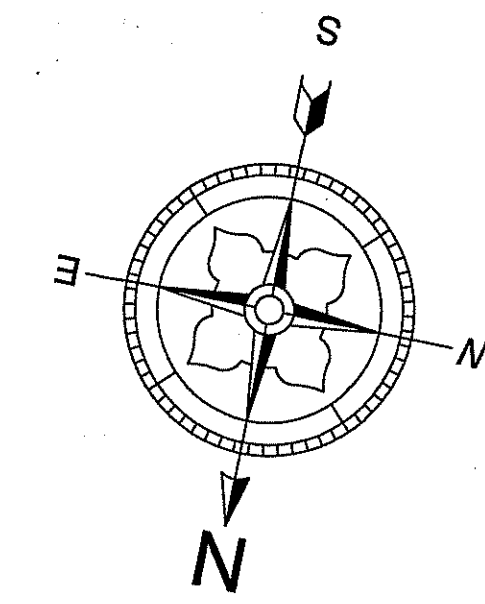

GROUND FLOOR PLAN

JOINERY DETAILS:-

G01	GRILL GATE	3.00 x 2.30	W1	ALU GLAZED WINDOW	2.44 x 1.50
G02	GRILL GATE	1.18 x 2.14	W2	ALU GLAZED WINDOW	1.22 x 1.50
G03	GRILL GATE	1.20 x 2.13	W3	ALU GLAZED WINDOW	2.24 x 1.35
G04	GRILL GATE	1.07 x 1.80	W4	ALU GLAZED WINDOW	1.22 x 1.25
G05	WOODEN DOOR	1.83 x 2.30	W5	ALU GLAZED WINDOW	1.07 x 1.35
G06	WOODEN DOOR	1.32 x 2.23	W6	ALU GLAZED WINDOW	2.22 x 1.25
G07	WOODEN DOOR	1.22 x 2.23	W7	ALU GLAZED WINDOW	1.83 x 1.22
G08	WOODEN DOOR	1.22 x 2.13	W8	ALU GLAZED WINDOW	1.22 x 1.25
G09	WOODEN DOOR	1.09 x 2.13	W9	ALU GLAZED WINDOW	1.00 x 1.22
G10	WOODEN DOOR	0.81 x 2.13	W10	ALU GLAZED WINDOW	1.22 x 1.25
G11	WOODEN DOOR	0.85 x 2.09	W11	ALU GLAZED WINDOW	0.75 x 1.22
G12	WOODEN DOOR	1.22 x 2.13	W12	ALU GLAZED WINDOW	1.83 x 1.00
G13	WOODEN DOOR	0.80 x 1.50	W13	ALU GLAZED WINDOW	1.70 x 1.22
G14	WOODEN DOOR	1.22 x 2.13	W14	ALU GLAZED WINDOW	3.06 x 0.60
G15	WOODEN DOOR	0.80 x 1.50	W15	ALU GLAZED WINDOW	2.44 x 0.60
G16	WOODEN DOOR	0.75 x 2.13	W16	ALU GLAZED WINDOW	1.83 x 0.60
G17	WOODEN DOOR	0.60 x 0.60	W17	ALU GLAZED WINDOW	1.22 x 0.60
G18	WOODEN DOOR	1.22 x 0.30	W18	ALU GLAZED WINDOW	0.81 x 0.60
G19	WOODEN DOOR	1.83 x 1.13	W19	ALU GLAZED WINDOW	1.83 x 0.60
G20	WOODEN DOOR	0.80 x 1.22	W20	ALU GLAZED WINDOW	1.22 x 0.40

PLINTH AREA DETAILS:-

AREA	SQ.M	SQ.FT.
GROUND FLOOR	2145.904	23098.32
PORCH	58.321	627.76
FIRST FLOOR	2183.919	23507.51
TERRACE FLOOR	196.545	1685.04
HEAD ROOM & MEZZ FLOOR	6728.608	72426.14

COLUMN REFERENCES:-

0.48 x 0.28 m
0.28 x 0.28 m
0.31 x 0.31 m
0.56 x 0.28 m
0.28 x 0.28 m
0.56 x 0.32 m
0.50 x 0.48 m

NOTES:-

- ALL DIMENSIONS ARE IN METRES
- ALL OPENING OF WINDOWS & VENTILATORS WITH A FIXED GRILL ARRANGEMENTS
- FLOOR LEVEL +0.00M IS TAKEN ON MESS BUILDING
- COLUMN SIZE INCLUDES PLASTERING

LEGEND:-

BRICK WALL
PARAPET WALL
WOOD PARTITION 0.1m th.
WOOD PARTITION 0.1m th.
AREA OF THE ROOM
FLOOR LEVEL/HEIGHT

FILE NAME: Soka Ikeda Madanakupparam
DATE OF SURVEY: 18/05/2017
DATE OF DRAWING: 18/05/2017
DWG. No: 01
SCALE: 1:100
SIZE: A0

AS-BUILT PLAN

AT SOKA IKEDA COLLEGE OF ARTS & SCIENCE FOR WOMEN, SETHU BHASKARA NAGAR, MADHANANGKUPPAM, CHENNAI-600099.

GROUND FLOOR PLAN



SOKA IKEDA COLLEGE OF ARTS & SCIENCE FOR WOMEN

SETHU BHASKARA NAGAR, MADHANANGKUPPAM, CHENNAI-600099. Ph: 977717405
www.sokacollege.in
e-mail: sokakollege@gmail.com

ATHI-MITHUNA SURVEYS

702, SUBASHI NAGAR, 200 FEET RING ROAD, KOLAYAR, CHENNAI - 600 050, INDIA.
Ph: 044 2555 4800, 04442 0834.
www.athimithunasurveys.com
e-mail: athimithunasurveys@gmail.com
athimithunasurveys@gmail.com

ORIENTATION:

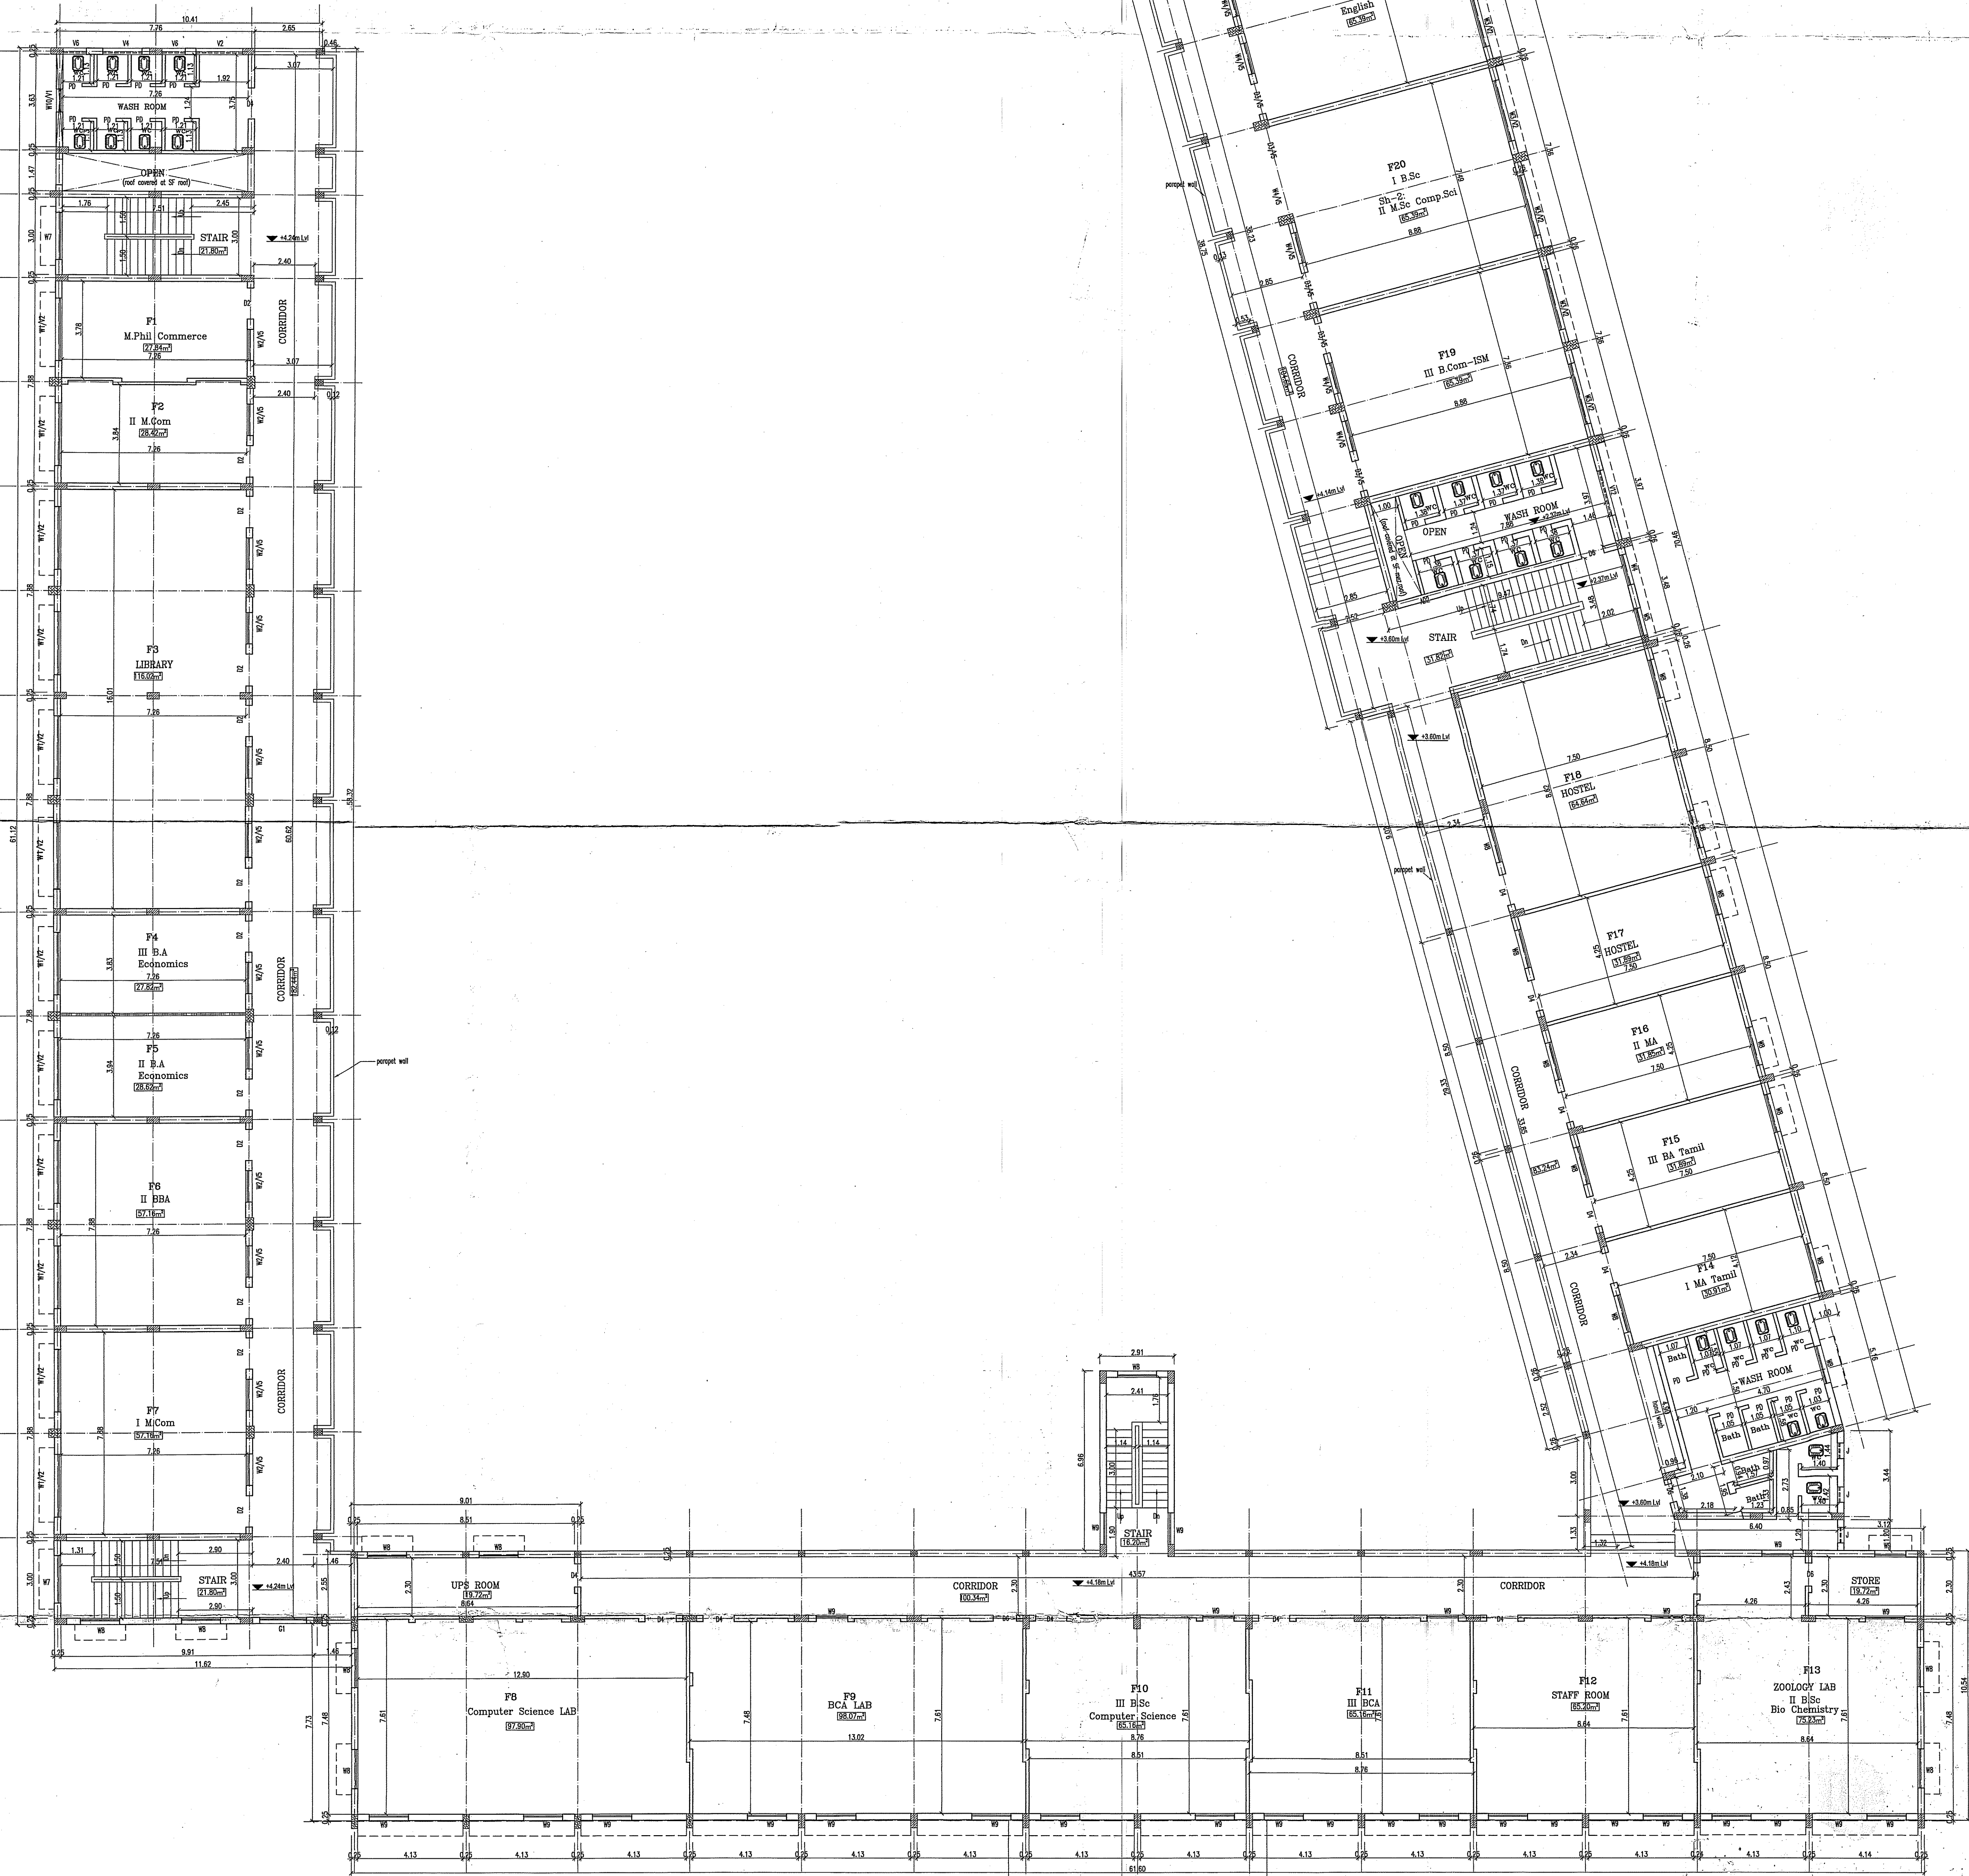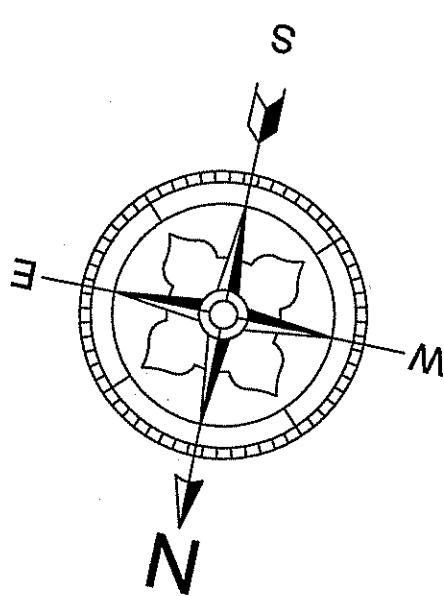

JOINERY DETAILS:-									
021	GRILL GATE	3.00 X 2.32	W1	ALL GLAZED WINDOW	2.44 X 1.50				
022	GRILL GATE	1.10 X 2.13	W2	ALL GLAZED WINDOW	1.22 X 1.50				
023	GRILL GATE	1.00 X 2.13	W3	ALL GLAZED WINDOW	1.44 X 1.50				
024	GRILL GATE	1.07 X 1.90	W4	ALL GLAZED WINDOW	1.22 X 1.38				
025	WOODEN DOOR	1.40 X 2.32	W5	ALL GLAZED WINDOW	1.07 X 1.38				
026	WOODEN DOOR	1.22 X 2.32	W6	ALL GLAZED WINDOW	2.00 X 1.22				
027	WOODEN DOOR	1.00 X 2.13	W7	ALL GLAZED WINDOW	1.83 X 1.22				
028	WOODEN DOOR	0.80 X 2.13	W8	ALL GLAZED WINDOW	1.50 X 1.22				
029	WOODEN DOOR	1.00 X 2.13	W9	ALL GLAZED WINDOW	1.00 X 1.22				
030	WOODEN DOOR	0.80 X 2.13	W10	ALL GLAZED WINDOW	0.70 X 1.22				
031	WOODEN DOOR	0.80 X 2.05	W11	ALL GLAZED WINDOW	1.83 X 1.00				
032	WOODEN DOOR	1.22 X 2.13	W12	ALL GLAZED WINDOW	1.70 X 1.22				
033	ALL DOOR	1.22 X 1.50	V1	ALL GLAZED WINDOW	0.80 X 0.80				
034	ALL DOOR	0.80 X 1.50	V2	ALL GLAZED WINDOW	0.80 X 0.80				
035	ALL DOOR	0.75 X 2.13	V3	ALL GLAZED WINDOW	1.83 X 0.80				
036	ALL DOOR	0.80 X 0.80	V4	ALL GLAZED WINDOW	1.83 X 0.80				
037	ALL DOOR	1.22 X 0.30	V5	ALL GLAZED WINDOW	1.22 X 0.80				
038	ALL DOOR	1.22 X 0.30	V6	ALL GLAZED WINDOW	1.83 X 0.80				
039	ALL DOOR	1.83 X 1.22	V7	ALL GLAZED WINDOW	1.83 X 0.40				
040	ALL DOOR	0.80 X 1.22	V8	ALL GLAZED WINDOW	1.22 X 0.40				

PLINTH AREA DETAILS:-			
AREA	SQ.M.	SQ.FT.	
GROUND FLOOR	2145.304	23098.32	
PORCH	58.321	627.76	
FIRST FLOOR	2163.919	23507.51	
SECOND FLOOR	2163.919	23507.51	
TERRACE FLOOR			
HEAD ROOM & MEZZ FLOOR	156.545	1685.04	
TOTAL PLINTH AREA	6728.608	72426.14	

COLUMN REFERENCES:-	
0.40 x 0.20 m	
0.50 x 0.20 m	
0.30 x 0.20 m	
0.55 x 0.20 m	
0.25 x 0.20 m	
0.50 x 0.20 m	
0.30 x 0.40 m	

- NOTES:-
1. ALL DIMENSIONS ARE IN METRES
 2. ALL OPENINGS OF WINDOWS & VENTILATORS WITH A FIXED GRILL ARRANGEMENTS
 3. FLOOR LEVEL +0.00M IS TAKEN ON MESS BUILDING
 4. COLUMN SIZE INCLUDES PLASTERING

LEGEND:-			
BRICK WALL			
PARAPET WALL			
ANG. PARTITION 0.1m H.			
WOOD PARTITION 0.1m H.			
AREA OF THE ROOM			
FLOOR LEVEL/HEIGHT			
FILE NAME: Soka IkedaMadanakuppam			
DATE OF SURVEY: 15/03/2017			
DATE OF DWG: 15/03/2017			
DWG. No: 02	SCALE: 1:100	SIZE: A0	

PROJECT	
AS-BUILT PLAN	
SITE	
AT SOKA IKEDA COLLEGE OF ARTS & SCIENCE FOR WOMEN, SETHU BHASKARA NAGAR, MADHANANGKUPPAM, CHENNAI-600099.	
TITLE	
FIRST FLOOR PLAN	

CLIENT	
SOKA IKEDA COLLEGE OF ARTS & SCIENCE FOR WOMEN	
72, SUBHASH NAGAR, 200 FEET RING ROAD, KOLATTAL, CHENNAI - 600 094, INDIA. PH: 044 2562 4000, 04445 98004. E-MAIL: sokaikeda@gmail.com	
SURVEYOR	
ATHI-MITHUNA SURVEYS	
72, SUBHASH NAGAR, 200 FEET RING ROAD, KOLATTAL, CHENNAI - 600 094, INDIA. PH: 044 2562 4000, 04445 98004. E-MAIL: athi_mithuna_surveys@gmail.com	





SOKA IKEDA COLLEGE OF ARTS & SCIENCE FOR WOMEN

SETHI BHASKARA NAGAR, MACHANANIKUPPAM,
CHENNAI-600099, PH:9577717456
www.sokaikedacollege.in
e-mail: sokacollege@rediffmail.com

ATHI-MITHUNA SURVEYS

72/2, SUBASH NAGAR, 200 FEET RING ROAD,
KOLATHUR, CHENNAI - 600 095, INDIA.
Tel: 044-2556 4810, 084464 09354.
www.athimithunasurveys.com
e-mail: athi.mithunasurveys@gmail.com
athi.mithunasurveys@rediffmail.com

ORIENTATION:

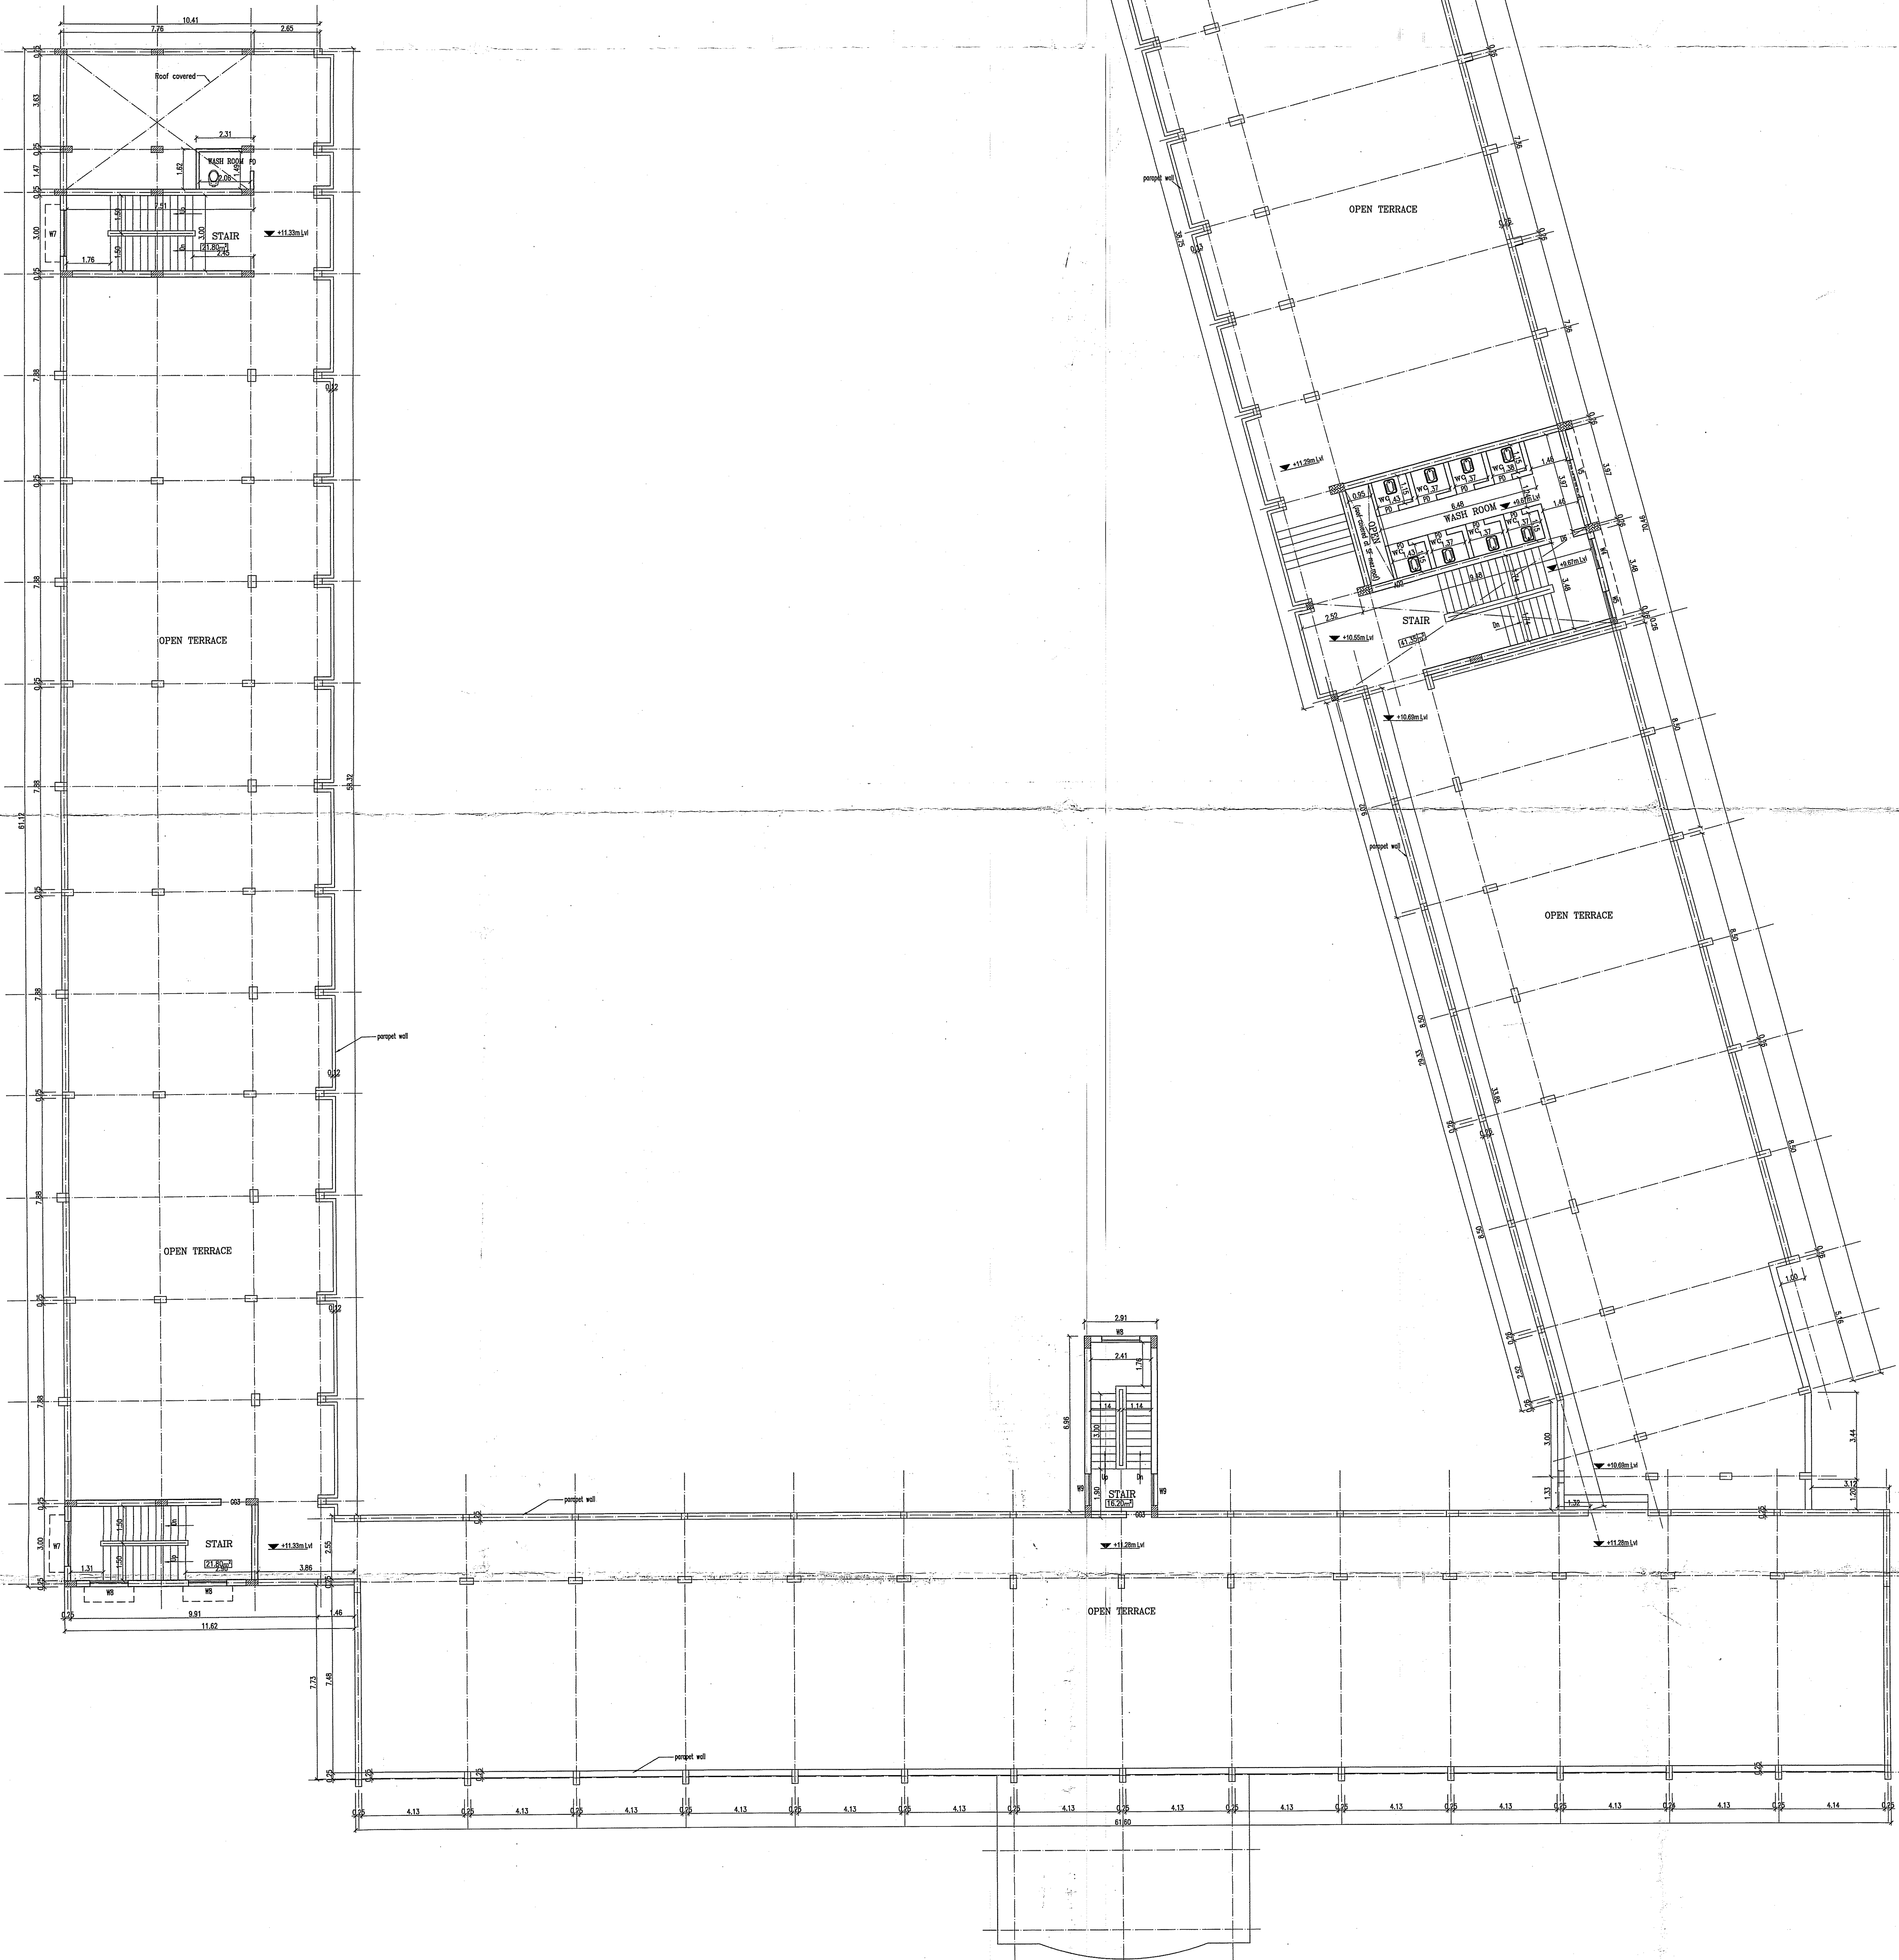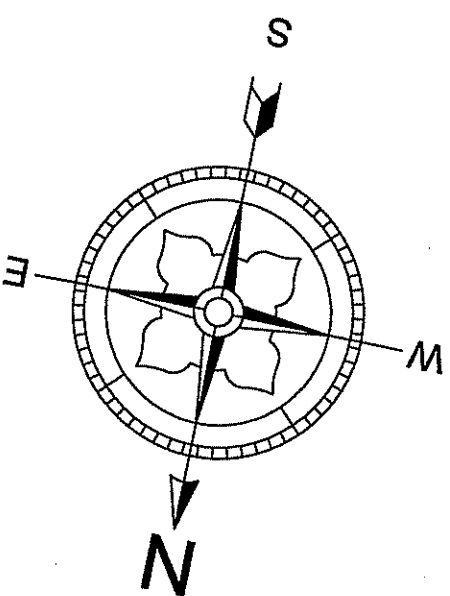

TERRACE FLOOR PLAN

JOINERY DETAILS:-

G01	GRILL DATE	3.00 x 2.30	W1	ALU GLAZED WINDOW	2.44 x 1.50
G02	GRILL DATE	1.18 x 2.13	W2	ALU GLAZED WINDOW	2.22 x 1.50
G03	GRILL DATE	1.00 x 2.13	W3	ALU GLAZED WINDOW	2.25 x 1.35
G04	GRILL DATE	1.07 x 1.99	W4	ALU GLAZED WINDOW	1.22 x 1.35
D1	WOODEN DOOR	1.83 x 2.30	W5	ALU GLAZED WINDOW	1.07 x 1.35
D2	WOODEN DOOR	1.22 x 2.25	W6	ALU GLAZED WINDOW	2.50 x 1.35
D3	WOODEN DOOR	1.22 x 2.25	W7	ALU GLAZED WINDOW	1.83 x 1.22
D4	WOODEN DOOR	1.22 x 2.25	W8	ALU GLAZED WINDOW	1.50 x 1.22
D5	WOODEN DOOR	1.22 x 2.25	W9	ALU GLAZED WINDOW	1.22 x 1.22
D6	WOODEN DOOR	1.22 x 2.25	W10	ALU GLAZED WINDOW	1.22 x 1.22
D7	WOODEN DOOR	1.22 x 2.25	W11	ALU GLAZED WINDOW	0.75 x 1.22
A01	ALL DOOR	1.22 x 2.13	W12	ALU GLAZED WINDOW	1.53 x 1.00
A02	ALL DOOR	1.22 x 2.13	W13	ALU GLAZED WINDOW	1.70 x 1.22
A03	ALL DOOR	0.85 x 1.86	V1	ALU GLAZED VENTILATOR	3.05 x 0.60
P	P V C DOOR	0.75 x 2.13	V2	ALU GLAZED VENTILATOR	2.48 x 0.60
J	ROD GUJI	0.60 x 0.60	V3	ALU GLAZED VENTILATOR	1.93 x 0.60
J1	ROD GUJI	1.22 x 0.30	V4	ALU GLAZED VENTILATOR	1.53 x 0.60
G1	GRILL	1.83 x 1.23	V5	ALU GLAZED VENTILATOR	1.22 x 0.60
G2	GRILL	0.90 x 1.22	V6	ALU GLAZED VENTILATOR	0.91 x 0.60
			V7	ALU GLAZED VENTILATOR	1.22 x 0.40
			V8	ALU GLAZED VENTILATOR	1.22 x 0.40

PLINTH AREA DETAILS:-

AREA	SQ.M	SQ.FT.
GROUND FLOOR	2145.004	23086.32
PORCH	48.301	522.76
FIRST FLOOR	2163.919	23507.51
SECOND FLOOR	2163.919	23507.51
TERRACE FLOOR	156.545	1685.04
HEAD ROOM & MEZZ FLOOR		
TOTAL PLINTH AREA	6728.608	72426.14

COLUMN REFERENCES:-

0.40 x 0.25 m
0.55 x 0.25 m
0.30 x 0.25 m
0.55 x 0.25 m
0.25 x 0.25 m
0.50 x 0.35 m
0.50 x 0.40 m

NOTES:-

1. ALL DIMENSIONS ARE IN METRES
2. ALL OPENING OF WINDOWS & VENTILATORS WITH A FIXED GRILL ARRANGEMENTS
3. FLOOR LEVEL +0.00M IS TAKEN ON MEISS BUILDING
4. COLUMN SIZE INCLUDES PLASTERING

LEGEND:-

BRICK WALL
PAINTED WALL
WOOD PARTITION 0.1m tk.
WOOD PARTITION 0.1m tk.
AREA OF THE ROOM
FLOOR LEVEL/HEIGHT

FILE NAME: Soka Ikeda Madanakuppam
DATE OF SURVEY: 15/05/2017
DATE OF DRAWING: 15/05/2017
DWG. No: 04
SCALE: 1:100
SIZE: A0

PROJECT AS-BUILT PLAN

SITE AT SOKA IKEDA COLLEGE OF ARTS & SCIENCE FOR WOMEN, SETHU BHASKARA NAGAR, MADHANANGKUPPAM, CHENNAI-600099.


TITLE TERRACE FLOOR PLAN

SOKA IKEDA COLLEGE OF ARTS & SCIENCE FOR WOMEN

CLIENT SETHU BHASKARA NAGAR, MADHANANGKUPPAM, CHENNAI-600099. Ph: 077777456 www.sokacollege.org

ATHI-MITHUNA SURVEYS

702, SUBASH NAGAR, 200 FEET RING ROAD, KOLATHUR, CHENNAI - 600 099, INDIA. Ph: 044 2556 4800, 094442 0934. www.athimithunasurveys.com e-mail: athi_mithunasurveys@gmail.com

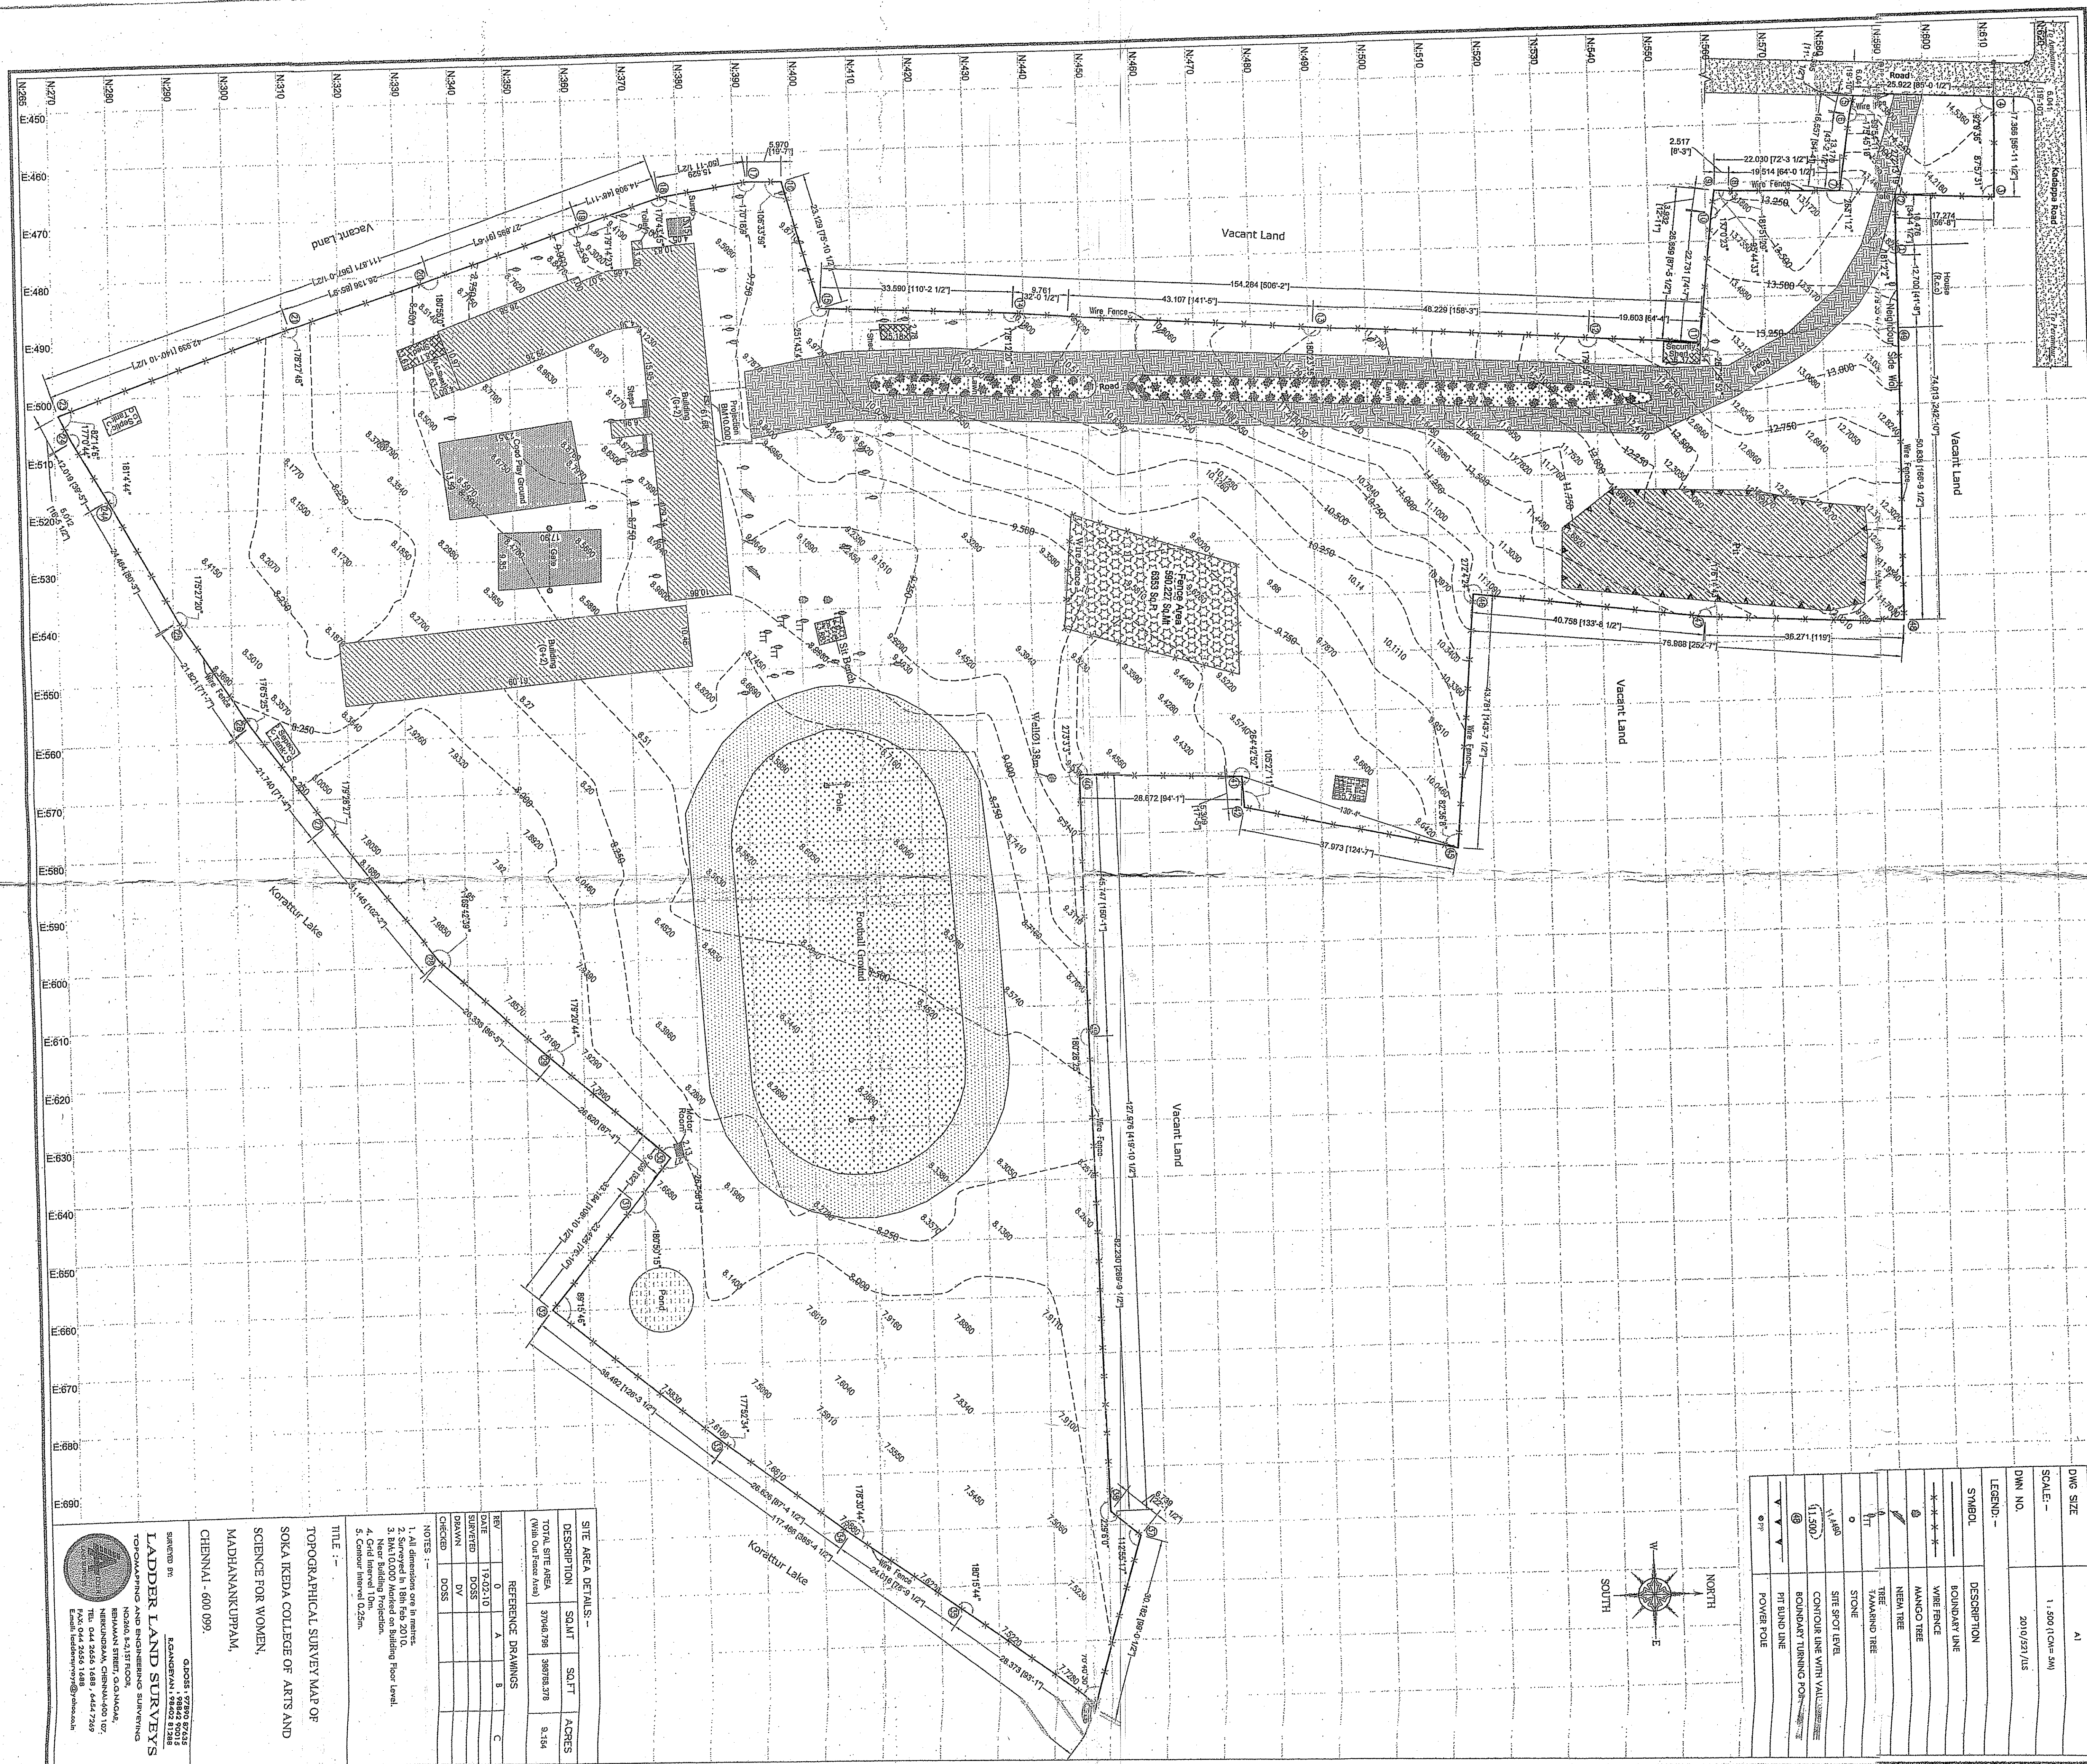

DWG. FILE NAME:	D:\PROJECTS\2010\5004\MEPA\DWG\5004-1.dwg	
DWG. SIZE	A1	
SCALE:-	1 : 500 (ICM = 5M)	
DWG. NO.	2010/531/ISS	
LEGEND:-		
SYMBOL	DESCRIPTION	
_____	BOUNDARY LINE	
— * * * —	WIRE FENCE	
⊗	MANGO TREE	
⊗	NEEM TREE	
⊗	TIER	
	MANGROVE TREE	
o	STONE	
1 x 600	SITE SPOT LEVEL	
(1:500)	CONTROL LINE WITH WALL	
⊗	BOUNDARY TURNING POINT	
— V — V —	PI BOUND LINE	
500	POWER POLE	